


REVISIONS			
REV	DESCRIPTION	DATE	APPROVED
A	AS BUILT	01/27/03	

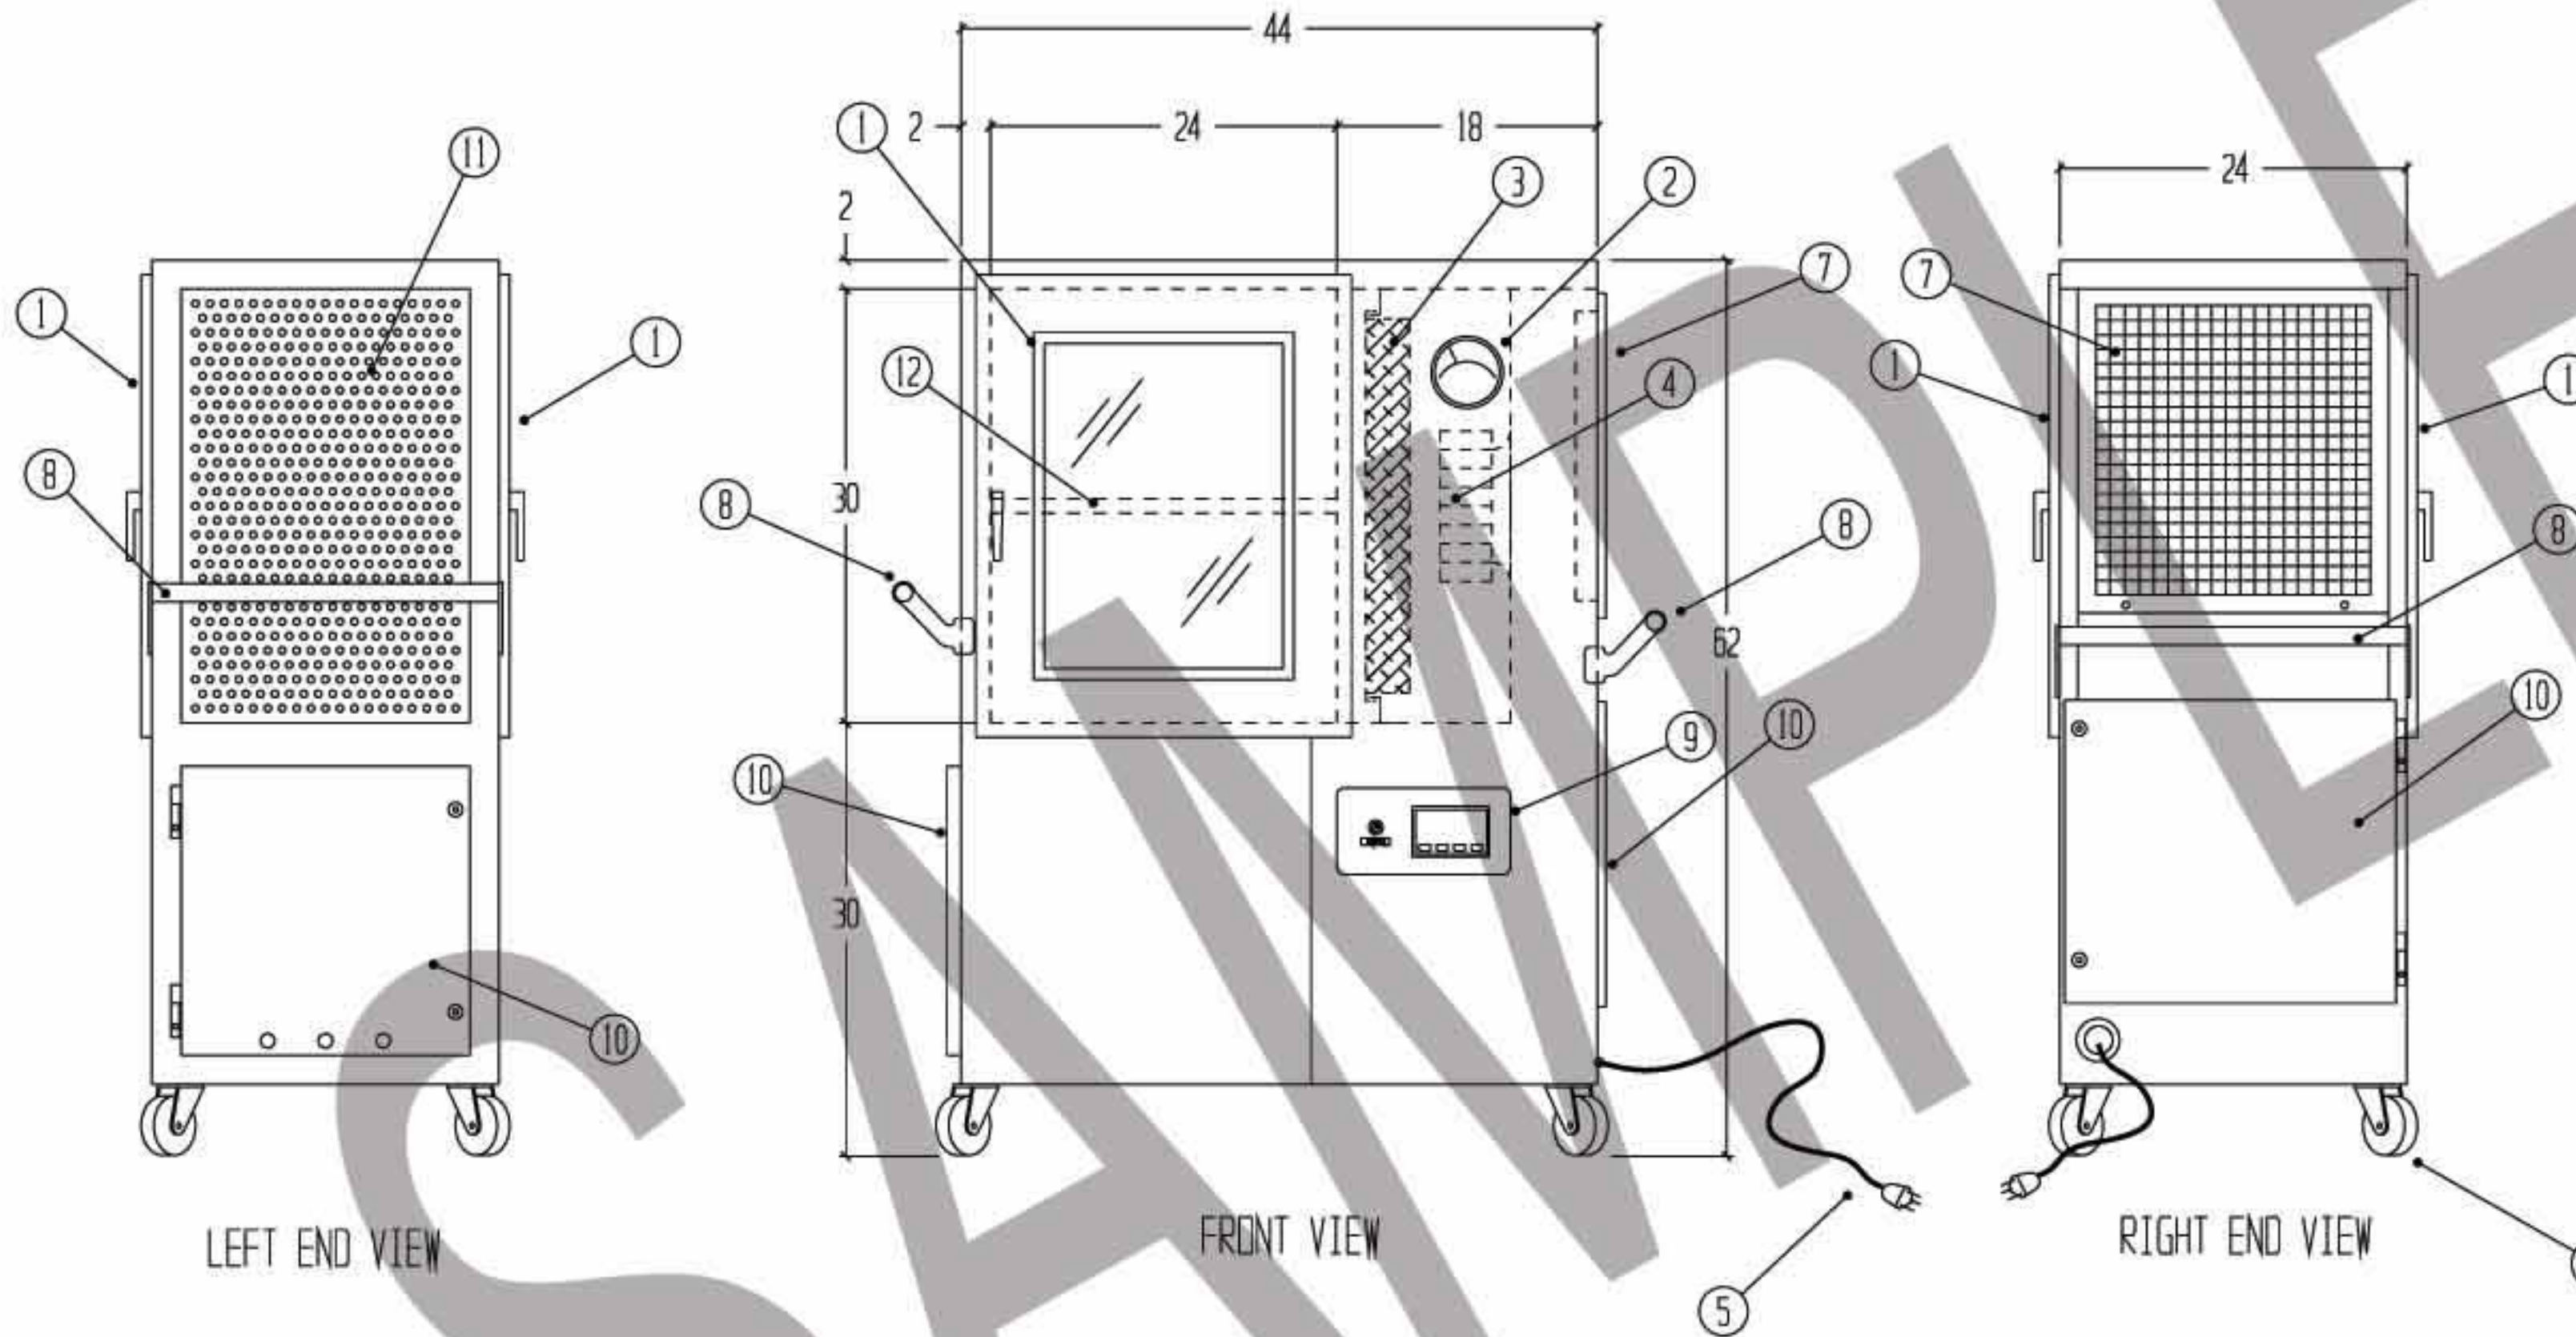

- ① 2 EA. STAINLESS STEEL DOORS WITH 1/4" THK. LEXAN INSERT, CONTINUOUS STAINLESS STEEL HINGE AND QUARTER TURN HANDLES
- ② MAGNETIC PRESSURE GAUGE
- ③ 1 EA. 18 X 25 1/2 X 3 1/2" ALUMINUM FRAMED HEPA FILTER, 99.99% EFFICIENT ON 0.3 MICRON SIZE PARTICLES, GEL SEALED, REPLACABLE FROM WITHIN THE CHAMBER
- ④ 1 EA. IMPELLER TYPE BLOWER WITH A 100W MOTOR 115V/ 60HZ WITH A TOTAL CAPACITY OF 400 CFM
- ⑤ RETRACTABLE POWER CORD
- ⑥ 4 EA. LOCKING SWIVEL CASTERS
- ⑦ 1 EA 20 X 20 STAINLESS STEEL PRE-FILTER GRILLE WITH 20 X 20 X 1" PLEATED, DISPOSABLE PRE-FILTER
- ⑧ STAINLESS STEEL PUSH-PULL HARDWARE
- ⑨ CONTROL PANEL WITH CONTROL SWITCH, INVERTER DISPLAY AND CHARGER DISPLAY
- ⑩ SERVICE ACCESS PANELS
- ⑪ PERFORATED STAINLESS STEEL EXHAUST GRILLE
- ⑫ 1 EA. 16 GA. STAINLESS STEEL SHELF

NOTES:

- UNIT CONSTRUCTION TO BE 16 GA. TYPE 304 STAINLESS STEEL WITH A #4 FINISH
- UNIT TO MEET ISO STANDARD 14644-1 (FED. STD. 209E)
- ELECTRICAL WIRING TO CONFORM TO NEC STANDARDS
- EQUIPPED WITH BATTERY AND CHARGER FOR APPROX. 2 HRS. RUNNING TIME

DRAWN FOR		TITLE LAMINAR FLOW TRANSPORT CART MODEL#PTC2430			
DRAWN BY LVB/JY		SIZE	JOB NO.	QWG NO.	REV A
APPROVED BY		SCALE 3/4" = 1'-0"	DATE 11-23-02	SHEET	